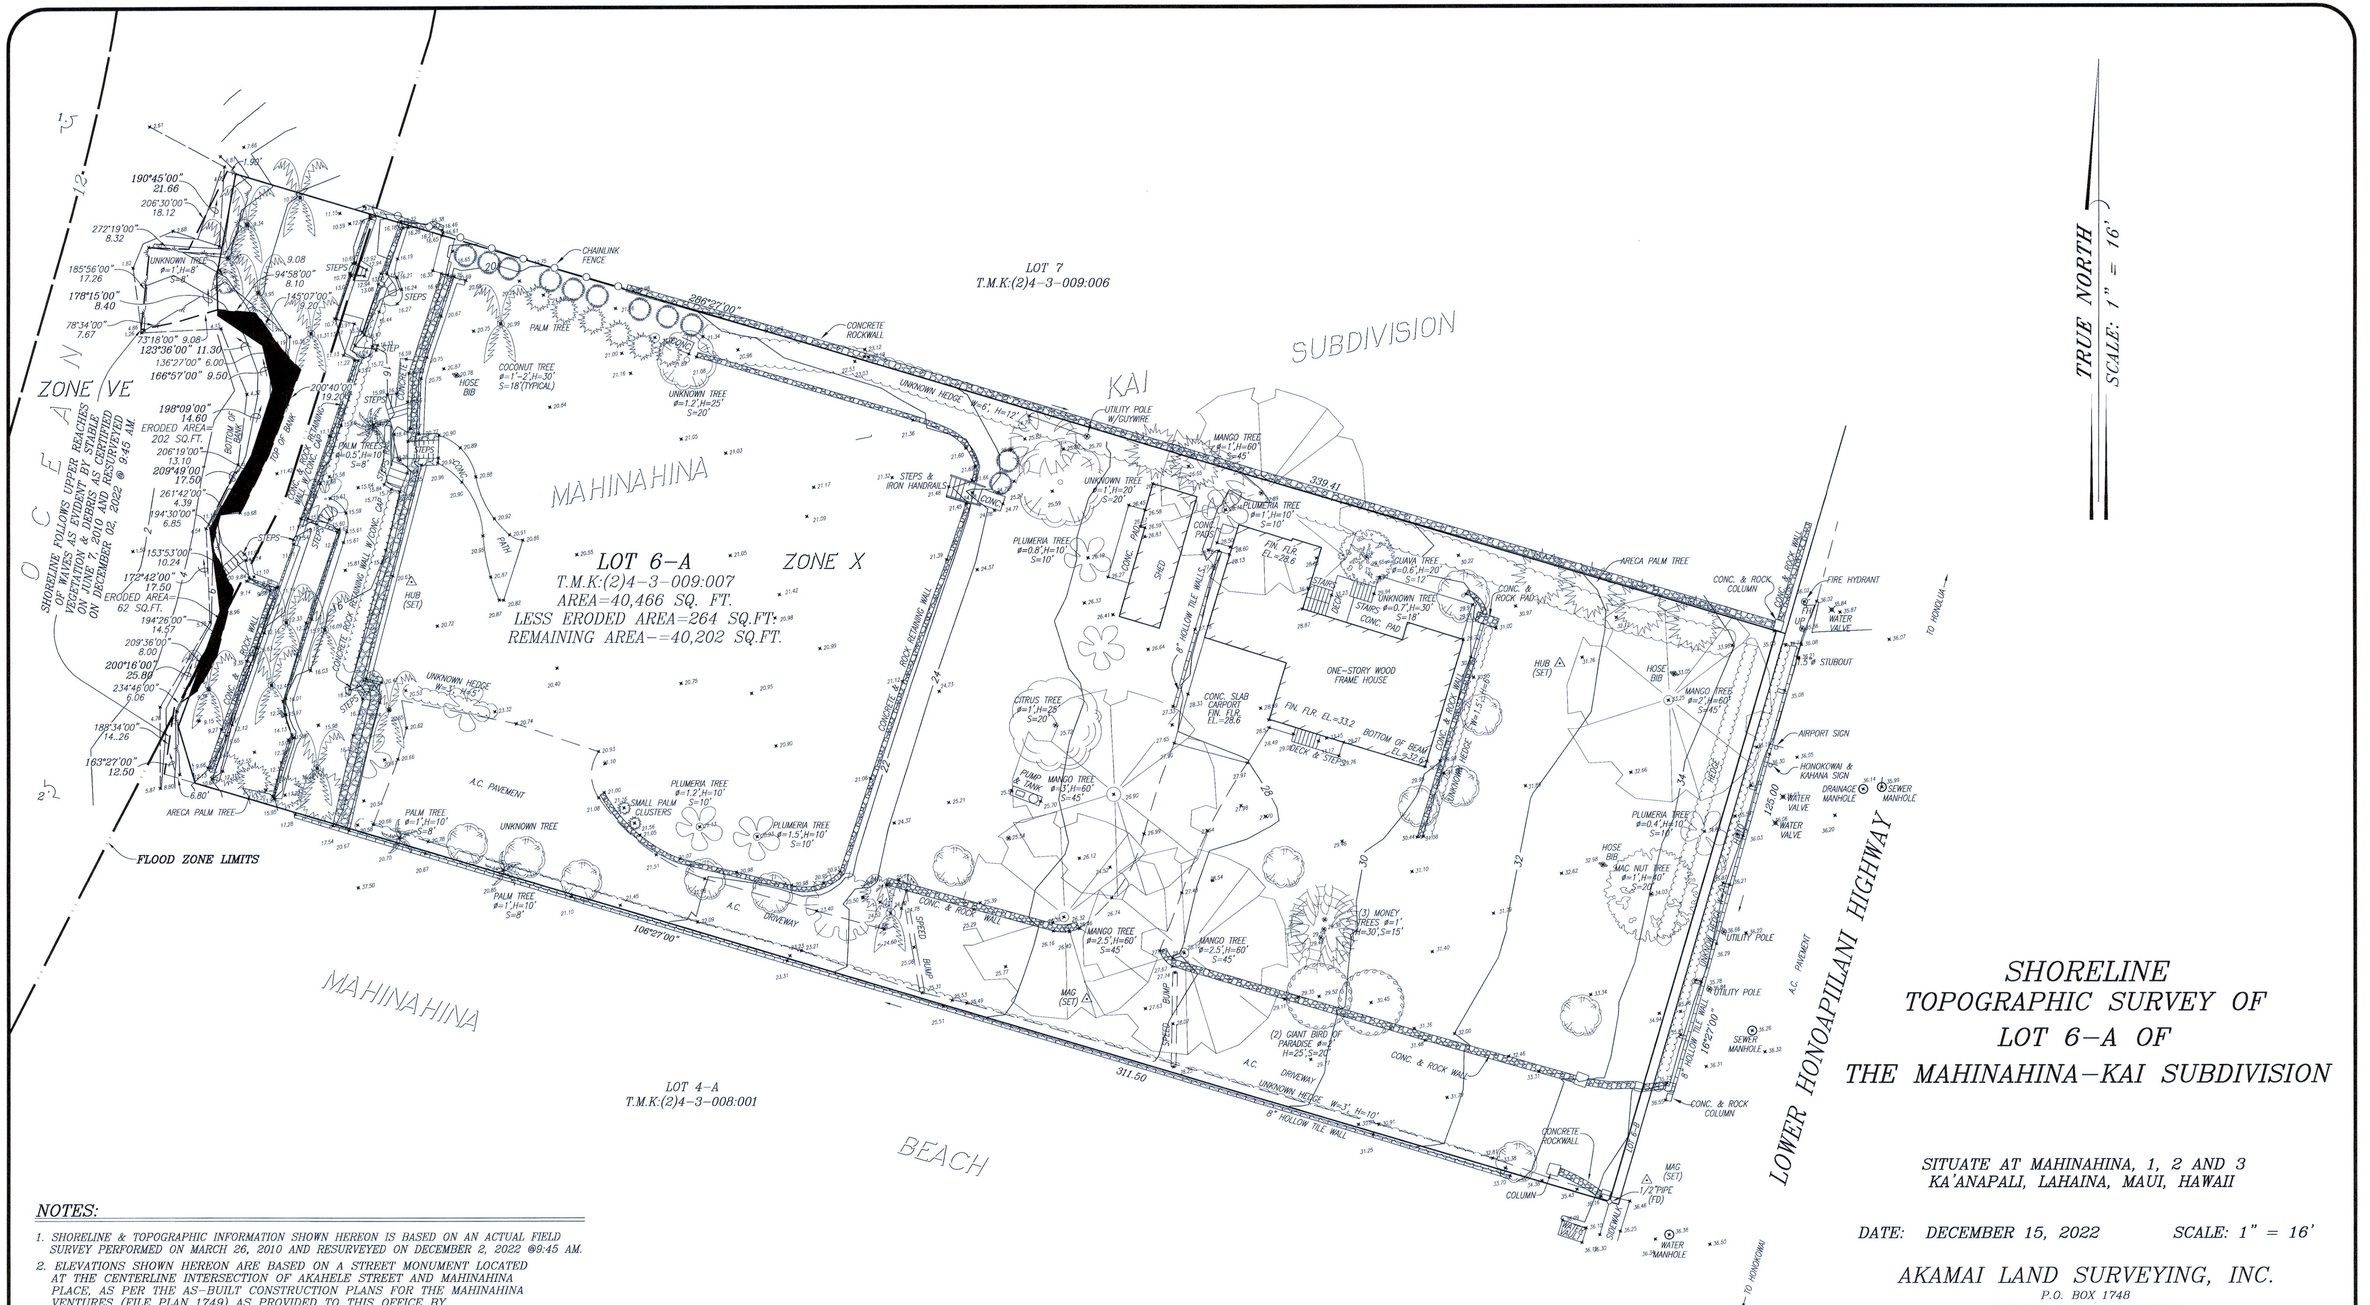

SHORELINE TOPOGRAPHIC SURVEY OF LOT 6-A OF THE MAHINAHINA-KAI SUBDIVISION

SITUATE AT MAHINAHINA, 1, 2 AND 3
KA'ANAPALI, LAHAINA, MAUI, HAWAII

DATE: DECEMBER 15, 2022 SCALE: 1" = 16'

AKAMAI LAND SURVEYING, INC.
P.O. BOX 1748
MAKAWAO, MAUI, HAWAII 96768

NOTES:

1. SHORELINE & TOPOGRAPHIC INFORMATION SHOWN HEREON IS BASED ON AN ACTUAL FIELD SURVEY PERFORMED ON MARCH 26, 2010 AND RESURVEYED ON DECEMBER 2, 2022 @9:45 AM.
2. ELEVATIONS SHOWN HEREON ARE BASED ON A STREET MONUMENT LOCATED AT THE CENTERLINE INTERSECTION OF AKAHELE STREET AND MAHINAHINA PLACE, AS PER THE AS-BUILT CONSTRUCTION PLANS FOR THE MAHINAHINA VENTURES (FILE PLAN 1749) AS PROVIDED TO THIS OFFICE BY WARREN S. UNEMORI ENGINEERING, INC. ON DECEMBER 11, 1995 AND REFER TO N.G.V.D. 1929 MEAN SEA LEVEL - LOCAL TIDAL DATUM.
3. AZIMUTHS AND COORDINATES SHOWN HEREON ARE RECORD AND REFER TO GOVERNMENT SURVEY TRIANGULATION STATION "LAINA".
4. <1> DENOTES PHOTO NUMBER, LOCATION AND DIRECTION.
5. SUBJECT PARCEL IS LOCATED IN FLOOD ZONE X - AREAS DETERMINED TO BE OUTSIDE THE 0.2% ANNUAL CHANCE FLOODPLAIN, PER FEMA FIRM PANEL NO. 15000302063F, DATED SEPTEMBER 19, 2012.
6. SUBJECT PARCEL IS LOCATED IN FLOOD ZONE VE - COASTAL FLOOD ZONE WITH VELOCITY HAZARD (WAVE ACTION); BFE DETERMINED.

PREPARED FOR:

MARK & JENNIFER AUGASON TRUST
4025 LOWER HONOAPIILANI HIGHWAY
LAHAINA, HI 96761

SHERMAN DUDLEY DEPONTE
LICENSED PROFESSIONAL LAND SURVEYOR
No. 6960
HAWAII, U.S.A.

THIS WORK WAS DONE BY ME OR UNDER MY DIRECT SUPERVISION.

12JAN'23

SHERMAN DUDLEY DEPONTE
LICENSED PROFESSIONAL LAND SURVEYOR
STATE OF HAWAII CERTIFICATE NO. 6960
EXPIRATION DATE: APRIL 30, 2024

T.M.K: (2) 4-3-009: 007

SHEET 1 OF 1

JOB NO. 222148-TOPO-SHORE-03JAN23